

Work Order ID 135045

July 27, 2015 1:07:46 PM

\*135045\*

RUSH!

Page 1

Item ID: D3076-1

Accept

\*N900040100\*

Setup Start \*NS1\*

Revision ID:

Stop \*NS2\*

Item Name: R22 Bearpaw

Start Date: 7/27/2015 Start Qty: 6.00

Required Date: 8/10/2015 Req'd Qty: 6.00

Cust Item ID:

Customer:

Reference:

Approvals: Process Plan: SK Date: 20150727 Tooling: \_\_\_\_\_ Date: \_\_\_\_\_  
QC: \_\_\_\_\_ Date: \_\_\_\_\_ SPC (Y/N): \_\_\_\_\_ Date: \_\_\_\_\_

Run Start \*NR1\*  
Stop \*NR2\*

| Sequence ID/<br>Work Center ID | Operation<br>Description   | Set Up/<br>Run Hours | Tool ID | Tool # | Plan<br>Code | Accept<br>Qty | Reject<br>Qty | Reject<br>Number | Insp.<br>Stamp |
|--------------------------------|---|----------------------|---------|--------|--------------|---------------|---------------|------------------|----------------|
| <b>Draw Nbr</b>                | <b>Revision Nbr</b>   |                      |         |        |              |               |               |                  |                |
| D3076                          | Rev A1   |                      |         |        |              |               |               |                  |                |
| 110                            | FLOW WATER JET   | 0.00                 |         |        |              |               |               |                  |                |
| <b>*110*</b>                   |   |                      |         |        |              |               |               |                  |                |
| Waterjet                       | Memo   | 0.00                 |         |        |              |               |               |                  |                |
| FLOW CNC Waterjet              | Cut Blank as per file D3076-1/BLANK   |                      |         |        |              |               |               |                  |                |
| 120                            | HAAS CNC VERTICAL MACHINING #1   | 0.00                 |         |        |              |               |               |                  |                |
| <b>*120*</b>                   |   |                      |         |        |              |               |               |                  |                |
| HAAS 1                         | Memo   | 0.00                 |         |        |              |               |               |                  |                |
| HAAS CNC vertical machine #1   | Note: (2) Bearpaw for (1) Kit 1-Inspect material for defects or damage prior to machining<br>2-Machine as per Folio FA186 and Dwg D30763-Identify as D3076-14-Debur |                      |         |        |              |               |               |                  |                |
| 130                            | QC2- Inspect parts off machine FA1/FAIB   | 0.00                 |         |        |              |               |               |                  |                |
| <b>*130*</b>                   |   |                      |         |        |              |               |               |                  |                |
| QC                             | Memo   | 0.00                 |         |        |              |               |               |                  |                |
| Quality Control                |   |                      |         |        |              |               |               |                  |                |

③

0215/07/30

8

Ø

DAS  
20  
9-89 15-08-07

8

Ø

DAS  
20  
9-89 15-08-07

DQA: \_\_\_\_\_ Date: \_\_\_\_\_



## WORK ORDER NON-CONFORMANCE / UPDATE

QA Closed: \_\_\_\_\_ Date: \_\_\_\_\_

Work Order update only ☐

|   |  |   |  |   |  |   |                       |                                              |  |
|---|--|---|--|---|--|---|-----------------------|----------------------------------------------|--|
| Work Order: _____<br><br>Part No. _____<br><br>NCR No. _____   |  | <b>DISPOSITION</b><br><br>Rework <input type="checkbox"/><br>Scrap <input type="checkbox"/><br>Use-as-is <input type="checkbox"/><br>Suspected Unapproved <input type="checkbox"/>   |  | <b>AGAINST DEPARTMENT/PROCESS</b><br><br><div style="display: flex; justify-content: space-between;"> <div>           Skid-tube <input type="checkbox"/><br/>           Machining <input type="checkbox"/><br/>           Thermoforming <input type="checkbox"/><br/>           Large Fab <input type="checkbox"/> </div> <div>           Cross tube <input type="checkbox"/><br/>           Small Fab <input type="checkbox"/><br/>           Finishing <input type="checkbox"/><br/>           Composite <input type="checkbox"/> </div> <div>           Water Jet <input type="checkbox"/><br/>           Prod. Eng. Coord. <input type="checkbox"/><br/>           Rec/Store/Packaging <input type="checkbox"/><br/>           Supplier <input type="checkbox"/> </div> <div>           Engineering <input type="checkbox"/><br/>           Quality <input type="checkbox"/><br/>           Other <input type="checkbox"/> </div> </div>   |  |   |                       |                                              |  |
| Date :   |  | Step #:   |  | QTY Effective :   |  |   | MRB (QS1042) Approval |                                              |  |
| Description Work Order Deviation   |  |   |  | Disposition   |  |   |                       | Completed By                                 |  |
|   |  |   |  |   |  |   |                       | Lead hand / Supervisor Approval Verification |  |
|   |  |   |  |   |  |   |                       |                                              |  |
|   |  |   |  |   |  |   |                       | QC / QA Coordinator Approval                 |  |
| <b>Root Cause</b><br><div style="display: flex; justify-content: space-between;"> <div>           Environment <input type="checkbox"/><br/>           Design <input type="checkbox"/><br/>           Doc/Data <input type="checkbox"/><br/>           Equip/Tooling <input type="checkbox"/><br/>           Handling/Pre <input type="checkbox"/><br/>           Material <input type="checkbox"/><br/>           Internal Transport <input type="checkbox"/><br/>           Tribal Knowledge <input type="checkbox"/><br/>           LOA <input type="checkbox"/><br/>           Substation <input type="checkbox"/><br/>           Past Expiry Date <input type="checkbox"/><br/>           Misidentified <input type="checkbox"/> </div> <div>           No Re-verification <input type="checkbox"/><br/>           Operator <input type="checkbox"/><br/>           Offset/Setup <input type="checkbox"/><br/>           Supplier <input type="checkbox"/><br/>           Training <input type="checkbox"/><br/>           Use for Testing <input type="checkbox"/><br/>           Poor Information <input type="checkbox"/><br/>           Rushing <input type="checkbox"/><br/>           Product Improvement <input type="checkbox"/><br/>           Process Improvement <input type="checkbox"/><br/>           Manufacturing Process <input type="checkbox"/><br/>           Past Due <input type="checkbox"/> </div> </div> |  | Pressure/Forced <input type="checkbox"/><br>Bending <input type="checkbox"/><br>Centre Not Concentric <input type="checkbox"/><br>Cracks <input type="checkbox"/><br>Crimp/Kink/Ripple/Wave <input type="checkbox"/><br>Cuffs <input type="checkbox"/><br>Crushing <input type="checkbox"/><br>Heat Treat <input type="checkbox"/><br>Wave/Twist in Tube <input type="checkbox"/><br>Marks/Chatter <input type="checkbox"/> |  | <b>FAULT CATEGORY</b><br><div style="display: flex; justify-content: space-between;"> <div>           Temperature/Cure <input type="checkbox"/><br/>           Set-up <input type="checkbox"/><br/>           BOM/Route <input type="checkbox"/><br/>           Broken/Damage/Defect <input type="checkbox"/><br/>           Inspection Incomplete/Unqualified <input type="checkbox"/><br/>           Contamination <input type="checkbox"/><br/>           Countersink <input type="checkbox"/><br/>           Cut Too Short <input type="checkbox"/><br/>           Instructions Incomplete/Unclear <input type="checkbox"/><br/>           Drill Holes <input type="checkbox"/> </div> <div>           Power Loss/Surge <input type="checkbox"/><br/>           Folio/Program <input type="checkbox"/><br/>           Grain <input type="checkbox"/><br/>           Weld <input type="checkbox"/><br/>           Wrong Stock Pulled <input type="checkbox"/><br/>           Out of Sequence <input type="checkbox"/><br/>           Off-set <input type="checkbox"/><br/>           Misabeled <input type="checkbox"/><br/>           Fit/Function <input type="checkbox"/><br/>           Misaligned/off center <input type="checkbox"/> </div> </div> |  | Positioned Wrong <input type="checkbox"/><br>Outside Dimensions <input type="checkbox"/><br>Over/Under tolerance <input type="checkbox"/><br>Part Incorrect <input type="checkbox"/><br>Part Lost/Missing <input type="checkbox"/><br>Part Moved <input type="checkbox"/><br>Drawing <input type="checkbox"/><br>Finish <input type="checkbox"/><br>Misread <input type="checkbox"/><br>Turning Sequence <input type="checkbox"/> |                       |                                              |  |
| OTHER : _____   |  |   |  |   |  |   |                       |                                              |  |



DQA: \_\_\_\_\_ Date: \_\_\_\_\_



## WORK ORDER NON-CONFORMANCE / UPDATE

QA Closed: \_\_\_\_\_ Date: \_\_\_\_\_

Work Order update only ☐

|   |   |   |   |   |   |
|---|---|---|---|---|---|
| Work Order: _____<br><br>Part No. _____<br><br>NCR No. _____   | <b>DISPOSITION</b><br><br>Rework <input type="checkbox"/><br>Scrap <input type="checkbox"/><br>Use-as-is <input type="checkbox"/><br>Suspected Unapproved <input type="checkbox"/>   | <b>AGAINST DEPARTMENT/PROCESS</b><br><br><div style="display: flex; justify-content: space-between;"> <div>           Skid-tube <input type="checkbox"/><br/>           Machining <input type="checkbox"/><br/>           Thermoforming <input type="checkbox"/><br/>           Large Fab <input type="checkbox"/> </div> <div>           Cross tube <input type="checkbox"/><br/>           Small Fab <input type="checkbox"/><br/>           Finishing <input type="checkbox"/><br/>           Composite <input type="checkbox"/> </div> <div>           Water Jet <input type="checkbox"/><br/>           Prod. Eng. Coord. <input type="checkbox"/><br/>           Rec/Store/Packaging <input type="checkbox"/><br/>           Supplier <input type="checkbox"/> </div> <div>           Engineering <input type="checkbox"/><br/>           Quality <input type="checkbox"/><br/>           Other <input type="checkbox"/> </div> </div> |   |   |   |
| Date :   | Step #:   | QTY Effective :   |   | MRB (QS1042) Approval   |   |
| Description Work Order Deviation   |   |   | Disposition   |   |   |
|   |   |   | Completed By   |   |   |
|   |   |   | Lead hand / Supervisor<br>Approval Verification   |   |   |
|   |   |   | QC / QA Coordinator<br>Approval   |   |   |
| Root Cause   |   | FAULT CATEGORY   |   |   |   |
| Environment <input type="checkbox"/><br>Design <input type="checkbox"/><br>Doc/Data <input type="checkbox"/><br>Equip/Tooling <input type="checkbox"/><br>Handling/Pre <input type="checkbox"/><br>Material <input type="checkbox"/><br>Internal Transport <input type="checkbox"/><br>Tribal Knowledge <input type="checkbox"/><br>LOA <input type="checkbox"/><br>Substation <input type="checkbox"/><br>Past Expiry Date <input type="checkbox"/><br>Misidentified <input type="checkbox"/> | No Re-verification <input type="checkbox"/><br>Operator <input type="checkbox"/><br>Offset/Setup <input type="checkbox"/><br>Supplier <input type="checkbox"/><br>Training <input type="checkbox"/><br>Use for Testing <input type="checkbox"/><br>Poor Information <input type="checkbox"/><br>Rushing <input type="checkbox"/><br>Product Improvement <input type="checkbox"/><br>Process Improvement <input type="checkbox"/><br>Manufacturing Process <input type="checkbox"/><br>Past Due <input type="checkbox"/> | Pressure/Forced <input type="checkbox"/><br>Bending <input type="checkbox"/><br>Centre Not Concentric <input type="checkbox"/><br>Cracks <input type="checkbox"/><br>Crimp/Kink/Ripple/Wave <input type="checkbox"/><br>Cuffs <input type="checkbox"/><br>Crushing <input type="checkbox"/><br>Heat Treat <input type="checkbox"/><br>Wave/Twist in Tube <input type="checkbox"/><br>Marks/Chatter <input type="checkbox"/>   | Temperature/Cure <input type="checkbox"/><br>Set-up <input type="checkbox"/><br>BOM/Route <input type="checkbox"/><br>Broken/Damage/Defect <input type="checkbox"/><br>Inspection Incomplete/Unqualified <input type="checkbox"/><br>Contamination <input type="checkbox"/><br>Countersink <input type="checkbox"/><br>Cut Too Short <input type="checkbox"/><br>Instructions Incomplete/Unclear <input type="checkbox"/><br>Drill Holes <input type="checkbox"/> | Power Loss/Surge <input type="checkbox"/><br>Folio/Program <input type="checkbox"/><br>Grain <input type="checkbox"/><br>Weld <input type="checkbox"/><br>Wrong Stock Pulled <input type="checkbox"/><br>Out of Sequence <input type="checkbox"/><br>Off-set <input type="checkbox"/><br>Misabeled <input type="checkbox"/><br>Fit/Function <input type="checkbox"/><br>Misaligned/off center <input type="checkbox"/> | Positioned Wrong <input type="checkbox"/><br>Outside Dimensions <input type="checkbox"/><br>Over/Under tolerance <input type="checkbox"/><br>Part Incorrect <input type="checkbox"/><br>Part Lost/Missing <input type="checkbox"/><br>Part Moved <input type="checkbox"/><br>Drawing <input type="checkbox"/><br>Finish <input type="checkbox"/><br>Misread <input type="checkbox"/><br>Turning Sequence <input type="checkbox"/> |
| OTHER : <input type="checkbox"/>   |   |   |   |   |   |

# Picklist Print

July 27, 2015 1:07:56 PM

Page 1

Work Order ID: 135045

**\*135045\***

Parent Item: D3076-1

**\*D3076-1\***

Parent Item Name: R22 Bearpaw

Start Date: 7/27/2015

Required Date: 8/10/2015

Start Qty: 6.00

Required Qty: 6.00

Comments: IPP Rev:C04.02.19Added tolerance and ref to DSK086-12 to Step 3KJ/JLM  
IPP Rev:D 08-11-10 New Manufacturing Method JLM Verified By:EC

| Component Item ID/<br>Item Name | Replacement<br>Item ID | Mfg/<br>Purch | Bin<br>Item | Primary<br>Location | Last<br>Location | Route<br>Seq ID | Unit of<br>Measure | Qty on<br>Hand | Qty per Kit | Total<br>Qty | Qty<br>Issued | Date<br>Issued | Status |
|---------------------------------|------------------------|---------------|-------------|---------------------|------------------|-----------------|--------------------|----------------|-------------|--------------|---------------|----------------|--------|
| MUHMWB10                        |                        | Purchased     | No          |                     |                  | 100             | sf                 | 272.5810       | 1           | 6            |               |                |        |

**\*MUHMWB10\***

UHMW 1" Black - 48"x120" Tivar Mfg.#52480104

**\*\***

02/15/07/30

Location

Loc Qty

Loc Code

MAT

216.714

m131661

43.514

m132063

173.2

MAT018

55.867

m131335

55.867

12

|                                             |  |                     |         |
|---------------------------------------------|--|---------------------|---------|
| <b>DART AEROSPACE LTD</b>                   |  | <b>Work Order:</b>  |         |
| <b>Description:</b> R22 Bearpaw             |  | <b>Part Number:</b> | D3076-1 |
| <b>Inspection Dwg:</b> D3076 <b>Rev:</b> A1 |  | <b>Page 1 of 1</b>  |         |

### FIRST ARTICLE INSPECTION CHECKLIST

☒ First Article      ☐ Prototype

| Inspection Sheet<br>Drawing Dimension |            | Tolerance     | Actual<br>Dimension | Accept | Reject | Method of<br>Inspection | Comments |
|---------------------------------------|------------|---------------|---------------------|--------|--------|-------------------------|----------|
| A                                     | 0.07 x 45° | +0.030/-0.010 | .072 x 45°          | ✓      |        | SLO8                    | VEN      |
| B                                     | 0.63       | +/-0.030      | .625                | ✓      |        | "                       |          |
| C                                     | 0.250      | +/-0.010      | .245                | ✓      |        | "                       |          |
| D                                     | 0.950      | +0.030/-0.010 | .945                | ✓      |        | "                       |          |
| E                                     | 5.50       | +/-0.030      | 5.500               | ✓      |        | "                       |          |
| F                                     | 0.25 x 45° | +/-0.030      | .250 x 45°          | ✓      |        | "                       |          |
| G                                     | 0.375      | +/-0.010      | .370                | ✓      |        | "                       |          |
| H                                     | 0.475      | +/-0.010      | .470                | ✓      |        | "                       |          |
| I                                     | 5.83       | +/-0.030      | 5.835               | ✓      |        | "                       |          |
| J                                     | 3.80       | +/-0.030      | 3.800               | ✓      |        | "                       |          |
| K                                     | 3.046      | +/-0.010      | 3.046               | ✓      |        | "                       |          |
| L                                     | 3.638      | +/-0.010      | 3.638               | ✓      |        | "                       |          |
| M                                     | 0.260      | +0.005/-0.000 | .260                | ✓      |        | "                       |          |
| N                                     | 0.93       | +/-0.030      | .929                | ✓      |        | "                       |          |
| O                                     | 0.30       | +0.030/-0.000 | .305                | ✓      |        | "                       |          |
| P                                     | 7.000      | +/-0.010      | 7.000               | ✓      |        | "                       |          |
| Q                                     | 10.14      | +/-0.030      | 10.140              | ✓      |        | SLO1                    | Tape     |
|                                       |            |               |                     |        |        |                         |          |
|                                       |            |               |                     |        |        |                         |          |
|                     |            |                    |            |                            |     |
|---------------------|------------|--------------------|------------|----------------------------|-----|
| DAS                 |            | DAS                |            |                            |     |
| <b>Measured by:</b> | 20<br>9-89 | <b>Audited by:</b> | 14<br>9-89 | <b>Prototype Approval:</b> | N/A |
| <b>Date:</b>        | 15-08-07   | <b>Date:</b>       | 15/08/10   | <b>Date:</b>               |     |


| Rev | Date     | Change                          | Revised by | Approved |
|-----|----------|---------------------------------|------------|----------|
| A   | 04.01.13 | New Issue      P/O D022-661-011 | KJ/RF      |          |



|                  |                |                                                   |                        |
|------------------|----------------|---------------------------------------------------|------------------------|
| DESIGN<br>#      | DRAWN BY<br>RF | DART AEROSPACE LTD<br>HAWKESBURY, ONTARIO, CANADA |                        |
| CHECKED<br>#     | APPROVED<br>#  | DRAWING NO.<br>D3076                              | REV. A<br>SHEET 1 OF 2 |
| DATE<br>02.01.08 |                | TITLE<br>R22 BEARPAW                              | SCALE<br>1:5           |
| A                | 02.01.08       | NEW ISSUE                                         |                        |
| A1               | 03.01.06       | <del>0.93</del> WAS <del>0.75</del>               |                        |

RELEASED  
02.01.10

SK 20150727  
135045

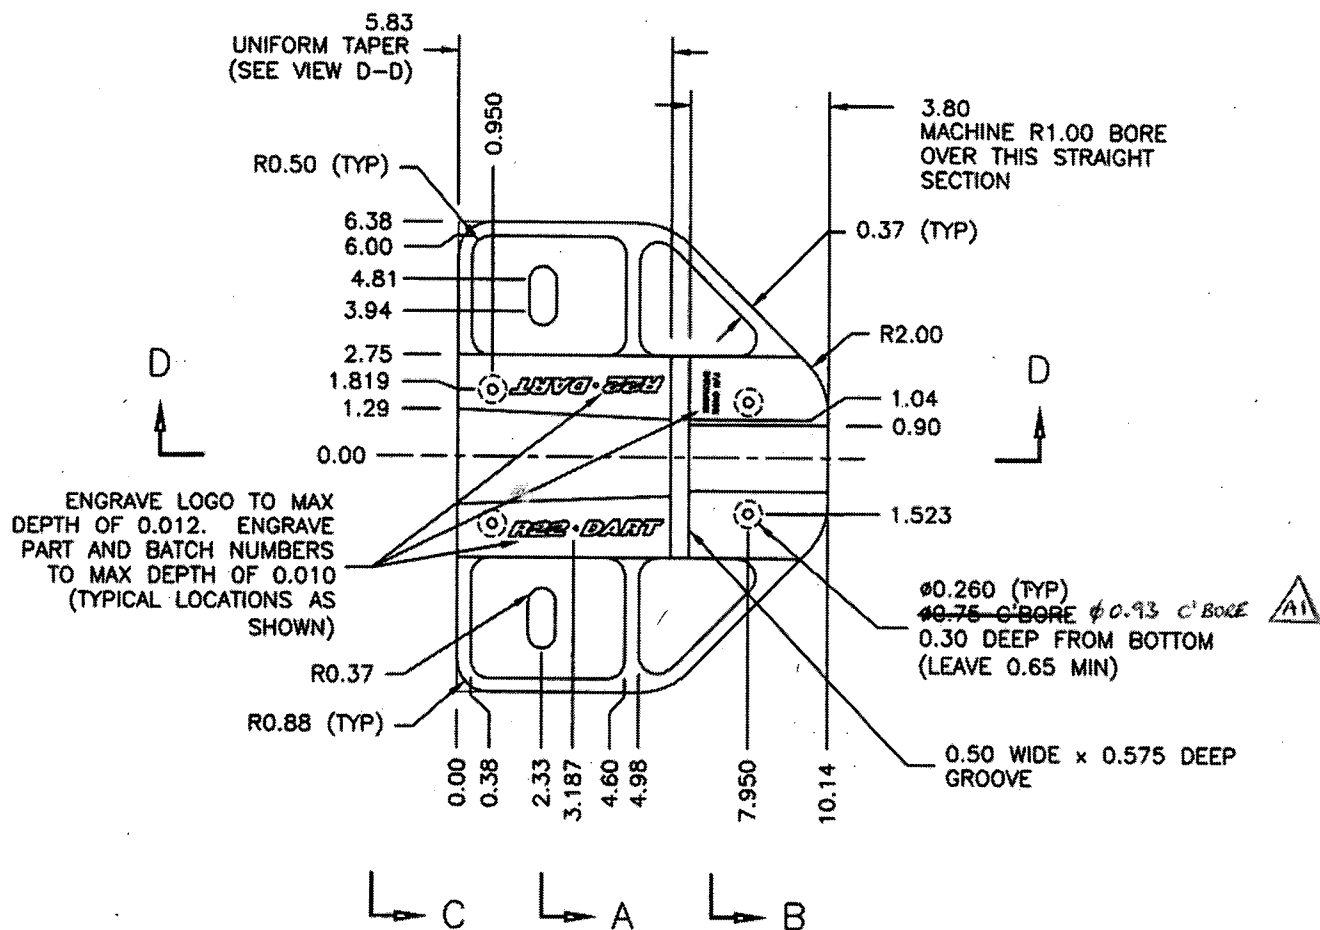

D3076-1 BEARPAW (FLAT PATTERN)

NOTES:


- 1) BEARPAW IS SYMMETRIC ABOUT CENTER LINE
- 2) MATERIAL: UHMW BLACK PER SPEC CONTROL DRAWING D2689, 1.00" THICK (MACHINE TO 0.950)
- 3) TOLERANCES ARE PER DART QSI 018 UNLESS OTHERWISE NOTED
- 4) ALL DIMENSIONS ARE IN INCHES

Copyright © 2002 by DART AEROSPACE LTD


THIS DOCUMENT IS PRIVATE AND CONFIDENTIAL AND IS SUPPLIED ON THE EXPRESS CONDITION THAT IT IS NOT TO BE USED FOR ANY PURPOSE OR COPIED OR COMMUNICATED TO ANY OTHER PERSON WITHOUT WRITTEN PERMISSION FROM DART AEROSPACE LTD.




|                  |                |                                                   |                        |
|------------------|----------------|---------------------------------------------------|------------------------|
| DESIGN<br>#      | DRAWN BY<br>RT | DART AEROSPACE LTD<br>HAWKESBURY, ONTARIO, CANADA |                        |
| CHECKED<br>#     | APPROVED<br>#  | DRAWING NO.<br>D3076                              | REV. A<br>SHEET 2 OF 2 |
| DATE<br>02.01.08 |                | TITLE<br>R22 BEARPAW                              | SCALE<br>1:4           |

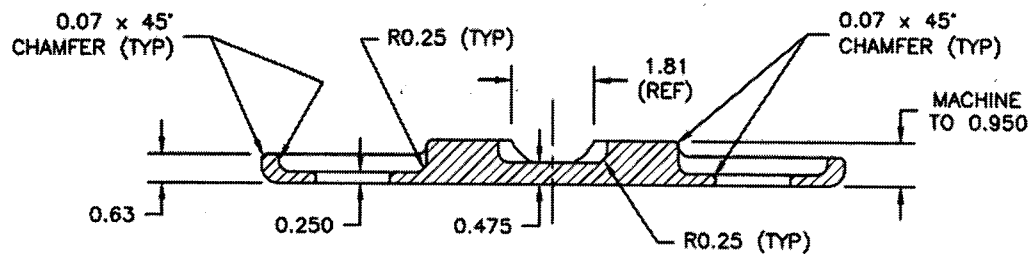


SECTION A-A

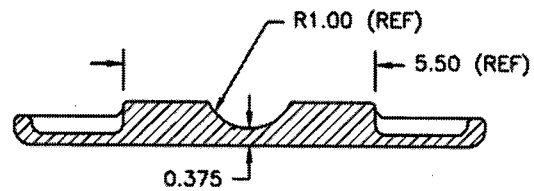

SECTION B-B

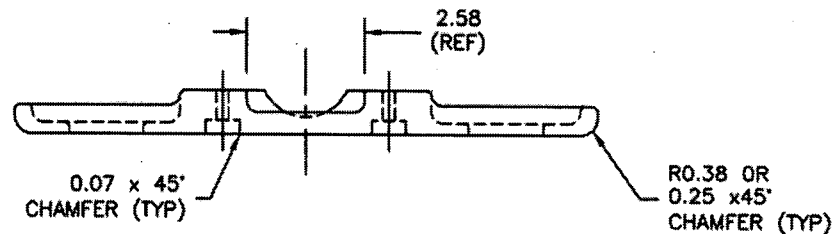

SECTION C-C

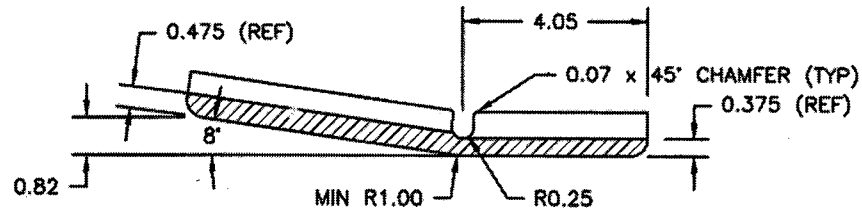

SECTION D-D (AFTER BENDING)

RELEASED  
02.01.10

Copyright © 2002 by DART AEROSPACE LTD

THIS DOCUMENT IS PRIVATE AND CONFIDENTIAL AND IS SUPPLIED ON THE EXPRESS CONDITION THAT IT IS NOT TO BE USED FOR ANY PURPOSE OR COPIED OR COMMUNICATED TO ANY OTHER PERSON WITHOUT WRITTEN PERMISSION FROM DART AEROSPACE LTD.